

PIPE RUN & BORE LOG

PVC Bore — B-3 to B-4

Project	Sample Project	Work type	PVC Bore
From	B-3	To	B-4
From GPS	38.501230, -97.602210	To GPS	38.501236, -97.601876
Work started	10/05/2026	Date completed	10/05/2026

As Specified

Pipe size6"


As Installed

Depth of cover5 ft

Quantities

Length bored96 ft

The Run

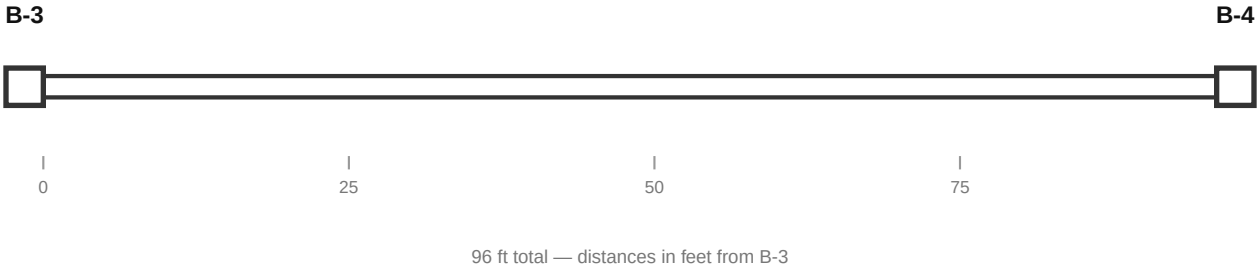

Work Performed

- Bore Pits — 10/05/2026
- Bore — 10/05/2026
- Pull Pipe — 10/05/2026
- Backfill Pits — 10/05/2026

Notes

Example sheet rendered from sample data. A real sheet prints exactly what the task recorded and leaves out anything it did not.